

Approved  
by BGP  
6/2000

Boylan ~~5-3~~

1/8

H-32

KINDLY REPLACE  
AS SHOWN

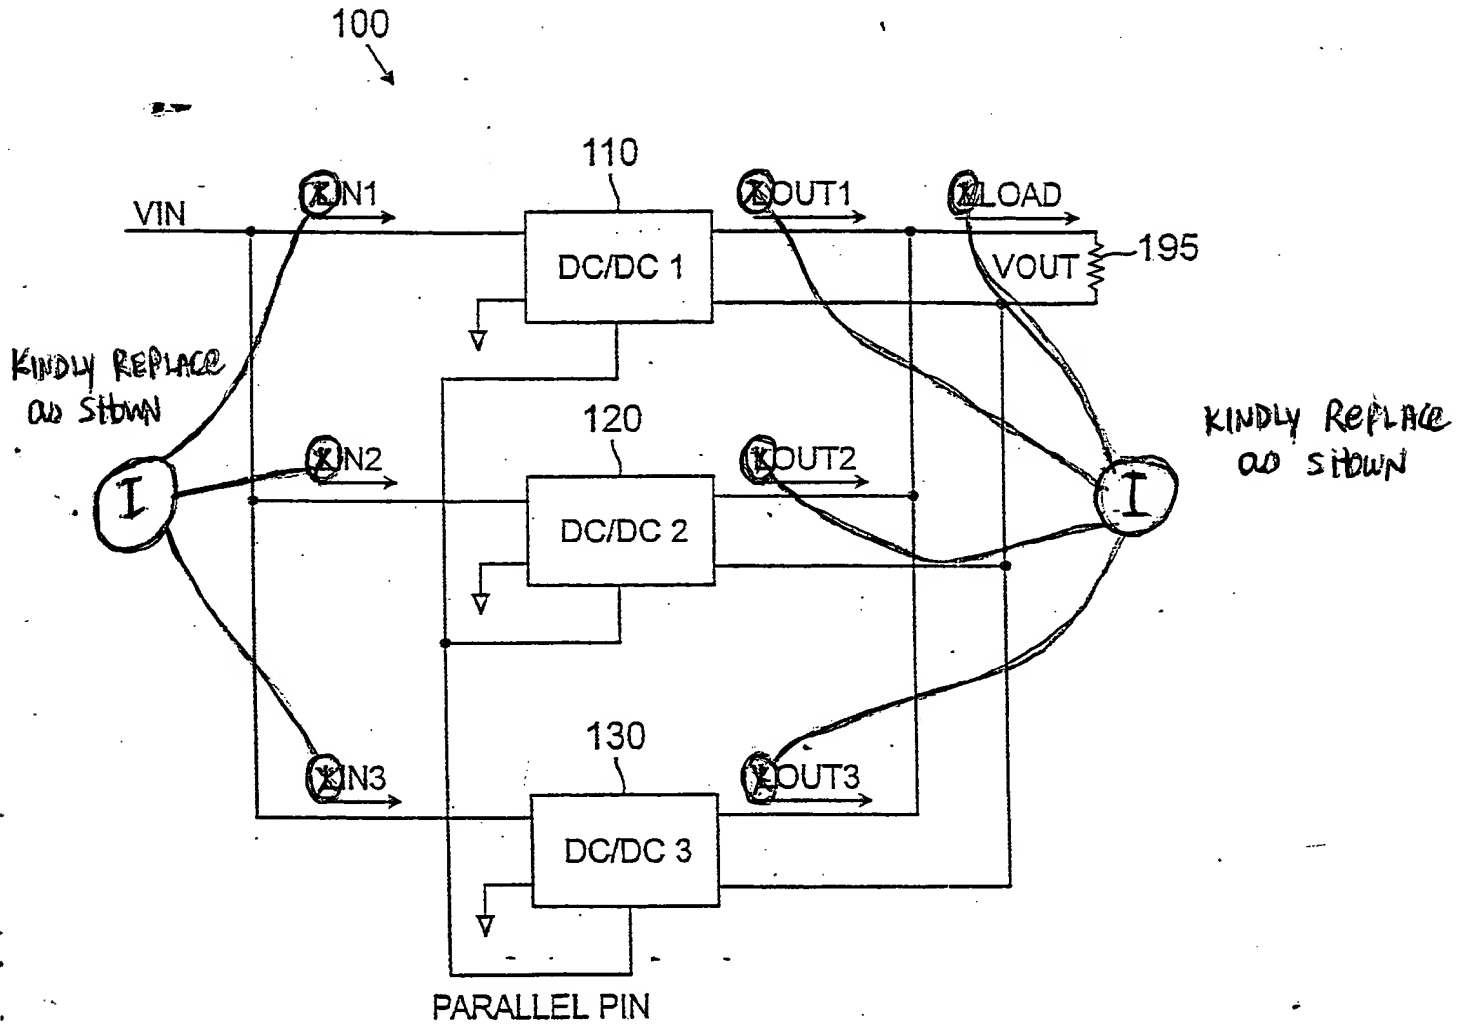


FIG. 1

Approved  
by B.P.  
6/2000

Boylan 5/13

2/8

11-32- KINDLY REPLACE  
as shown

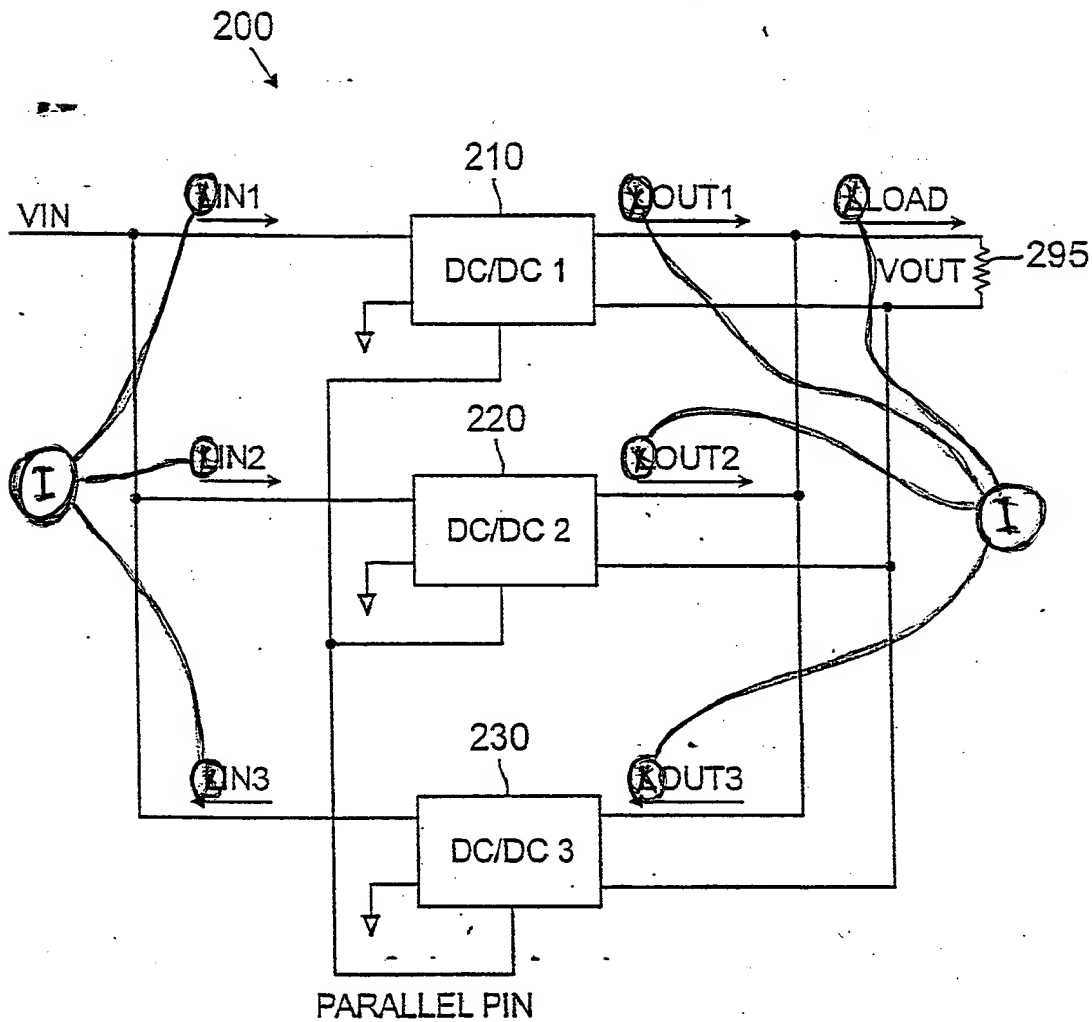


FIG. 2



KINDLY REPLACE  
AS SHOWN



Approved  
by B.F.  
6/2000

Boylan 543

4/8

11-32

KINDLY REPLACE  
AS SHOWN

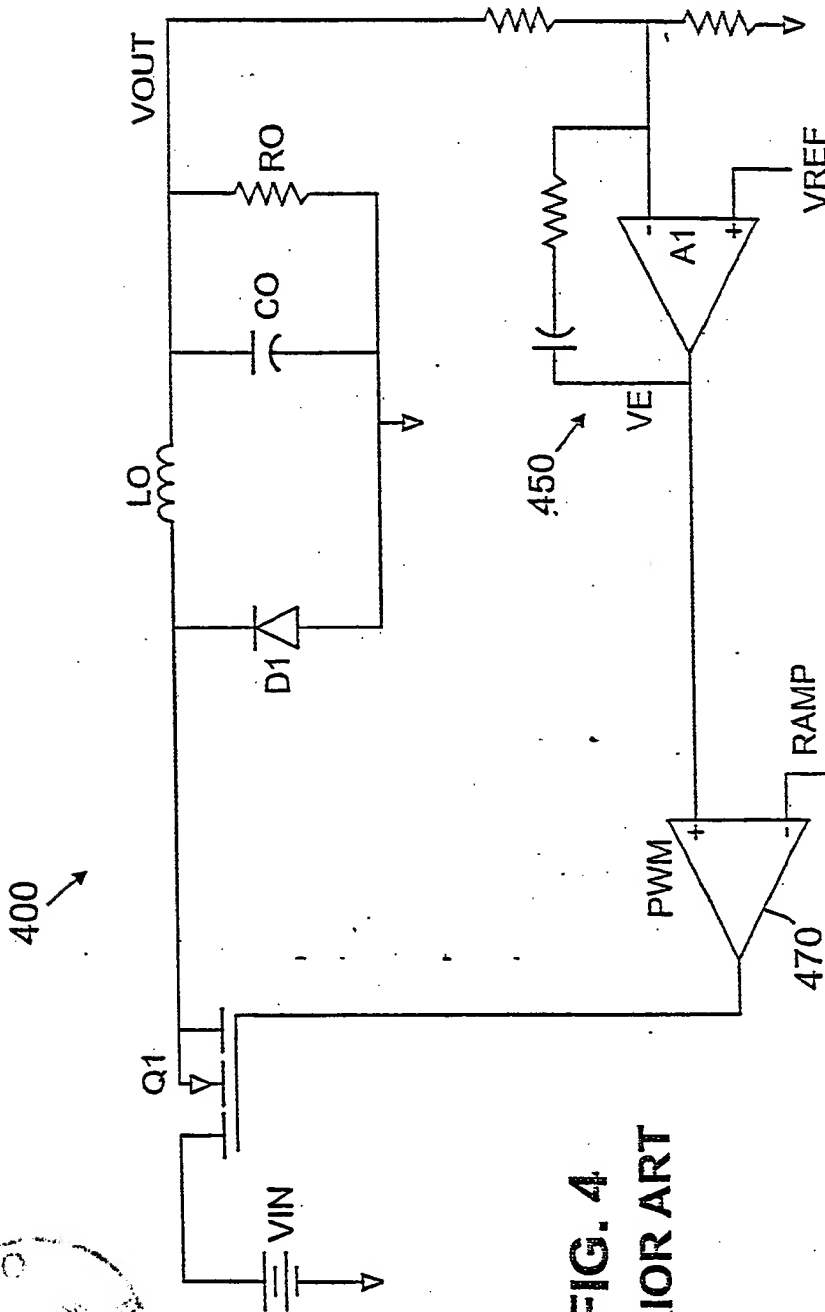


FIG. 4  
PRIOR ART

Approved  
by BP  
6/2000

Boylan 543

5/8

11-32

KINDLY REPLACE  
AS SHOWN

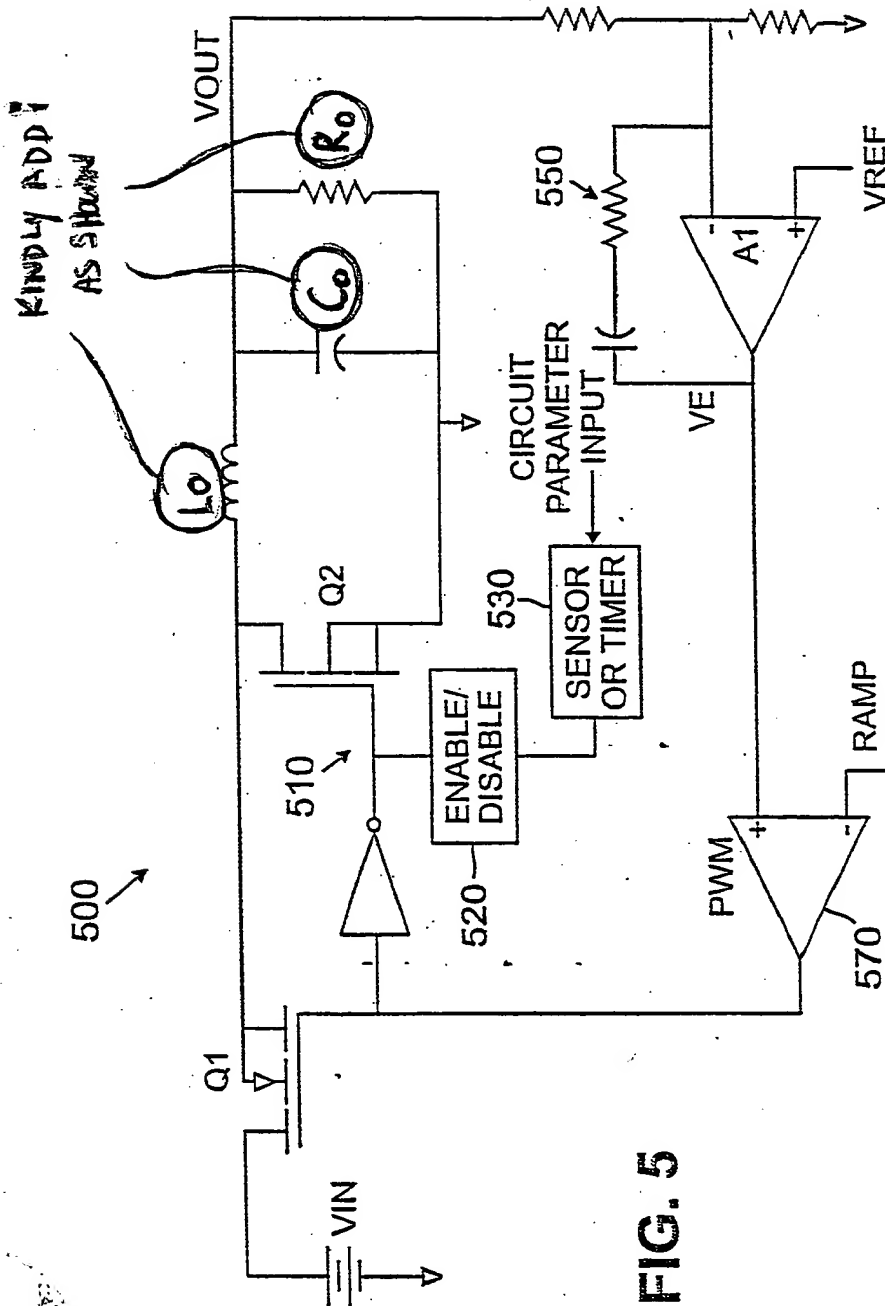


FIG. 5

600

KINDLY REPLACE CU SHOWN

Approved  
by B.P.  
6/2000

Boylan 5X13

6/8

11-32

KINDLY REPLACE  
CU SHOWN

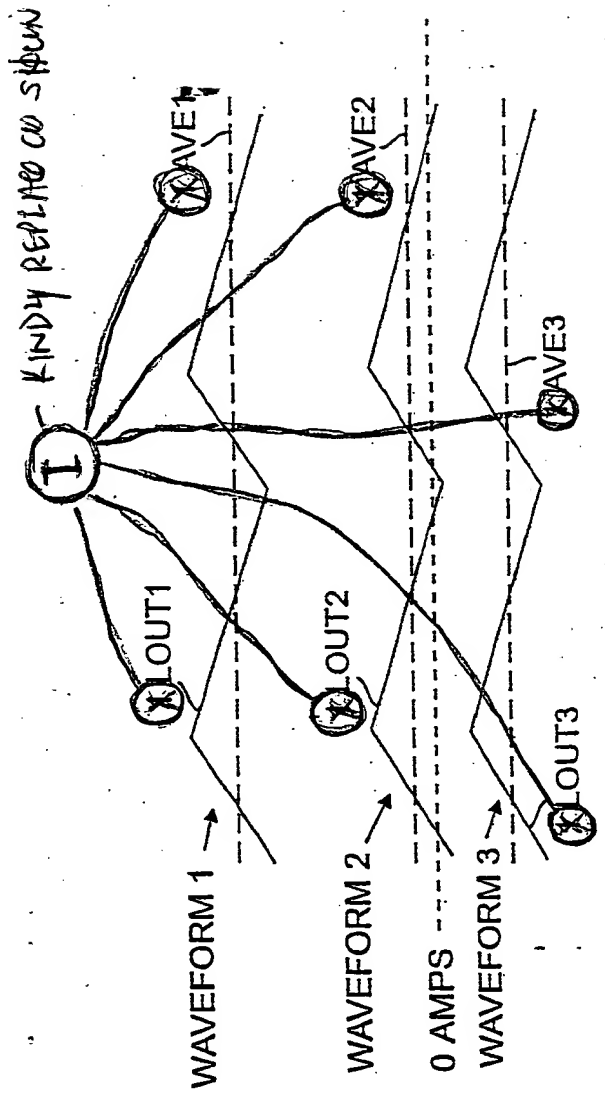


FIG. 6

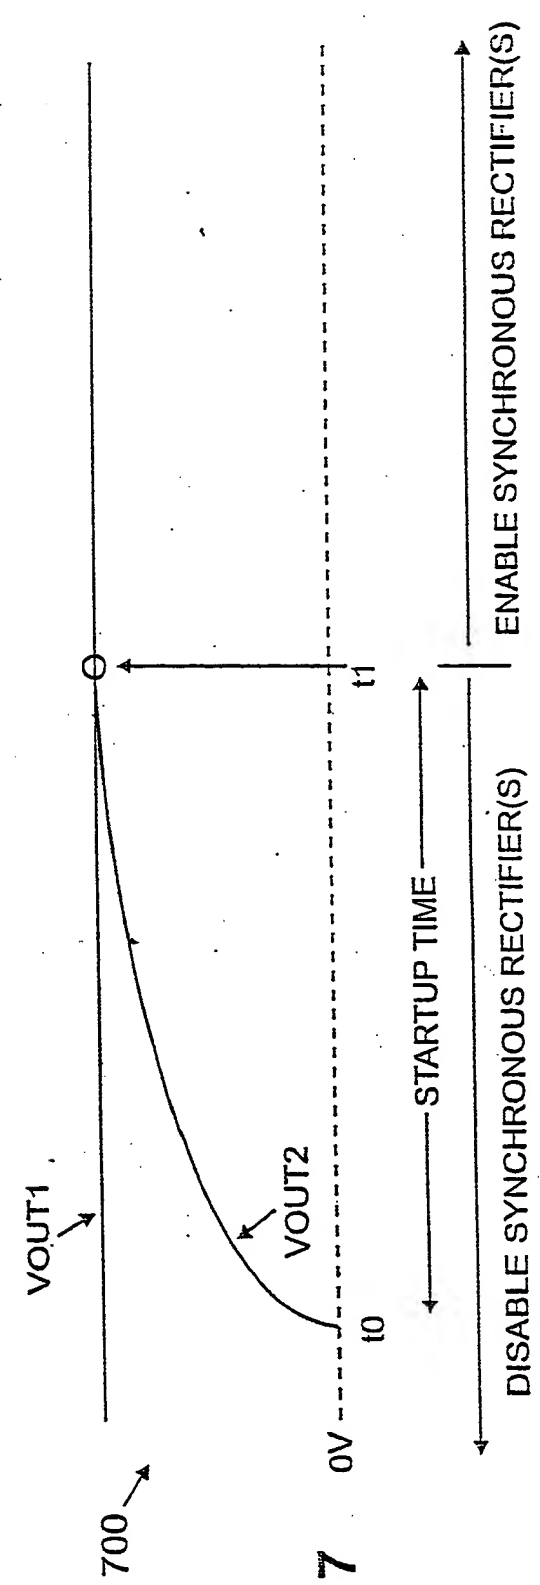


FIG. 7

Approved  
by B.G.  
6/2000

Boyian 5X13

(H-32)

KINDLY REPLACE  
AS SHOWN

7/8

KINDLY ADD  
RED LINES  
AS SHOWN

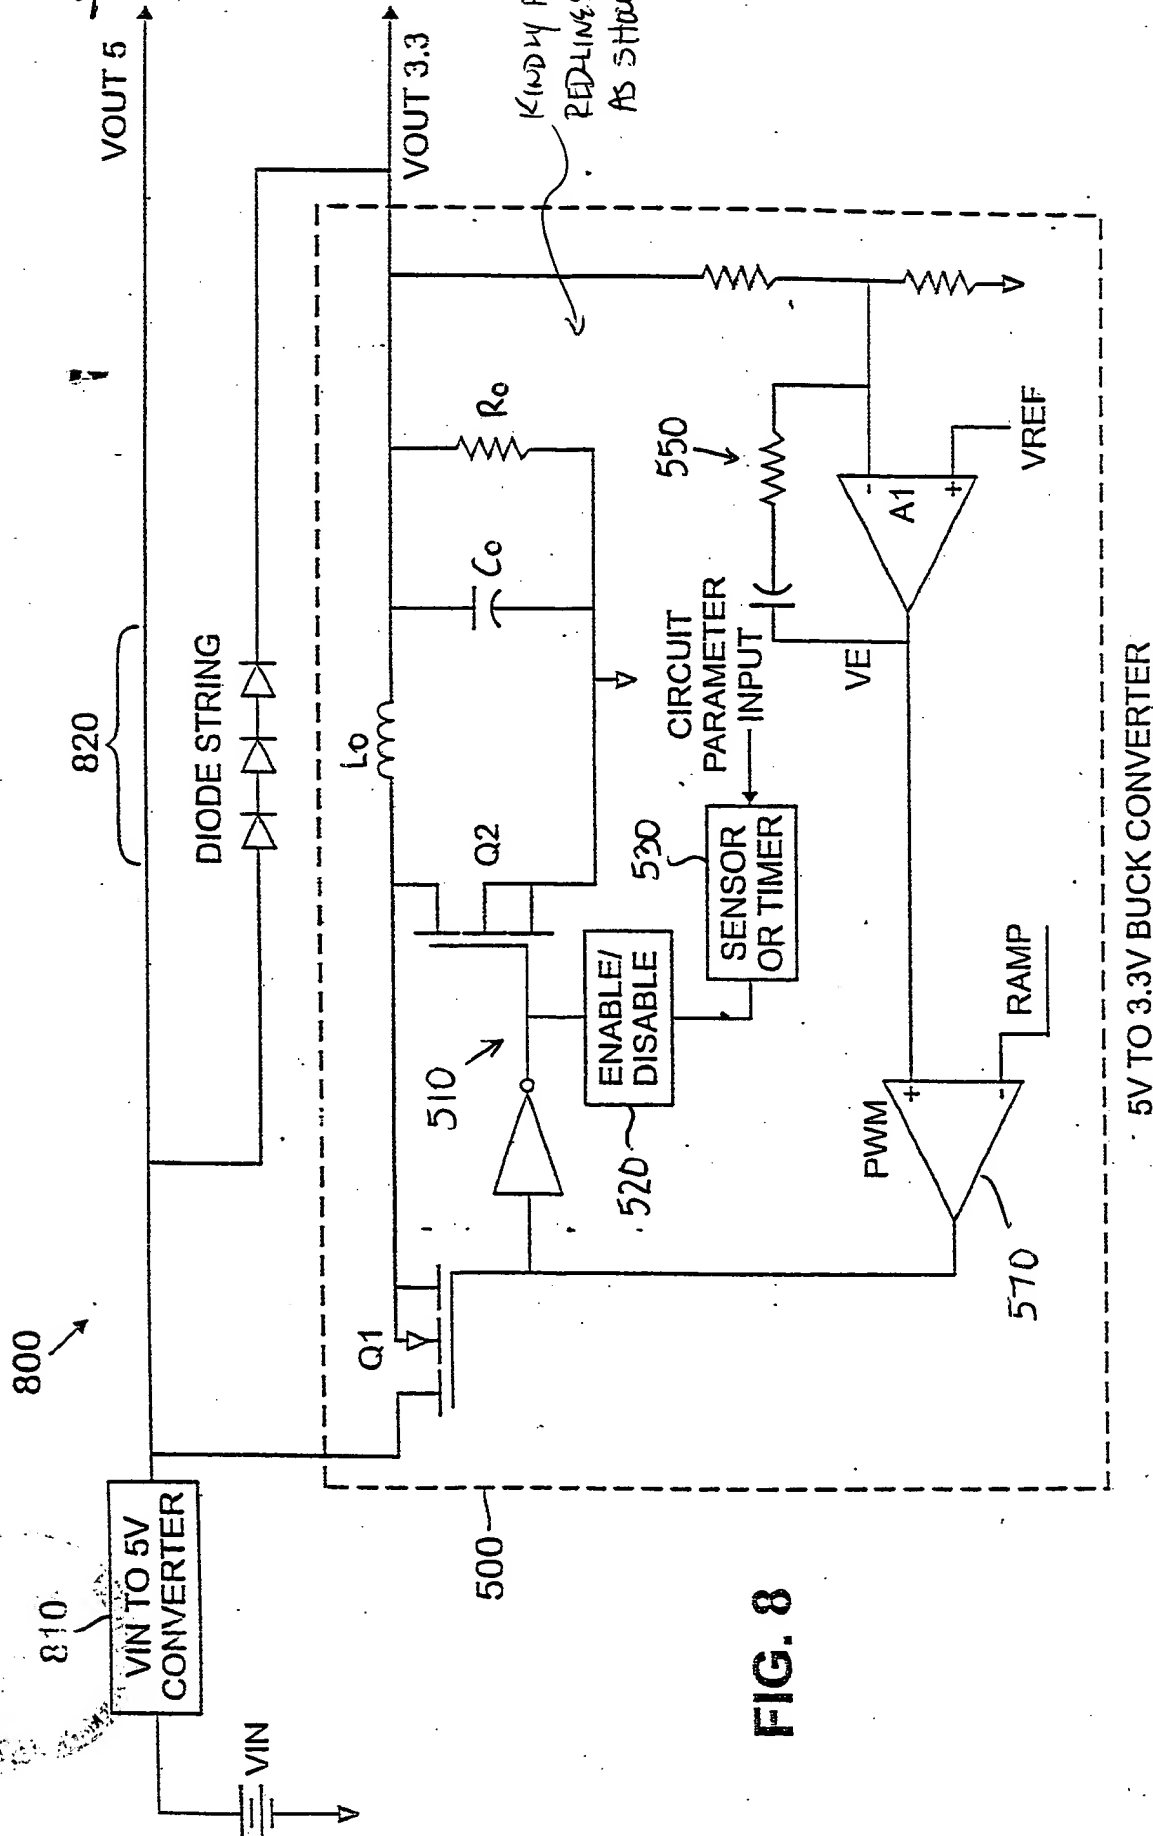


FIG. 8

8/8

A-32

KINDLY REPLACE  
AS SHOWN

Approved  
by BAs  
6/2000

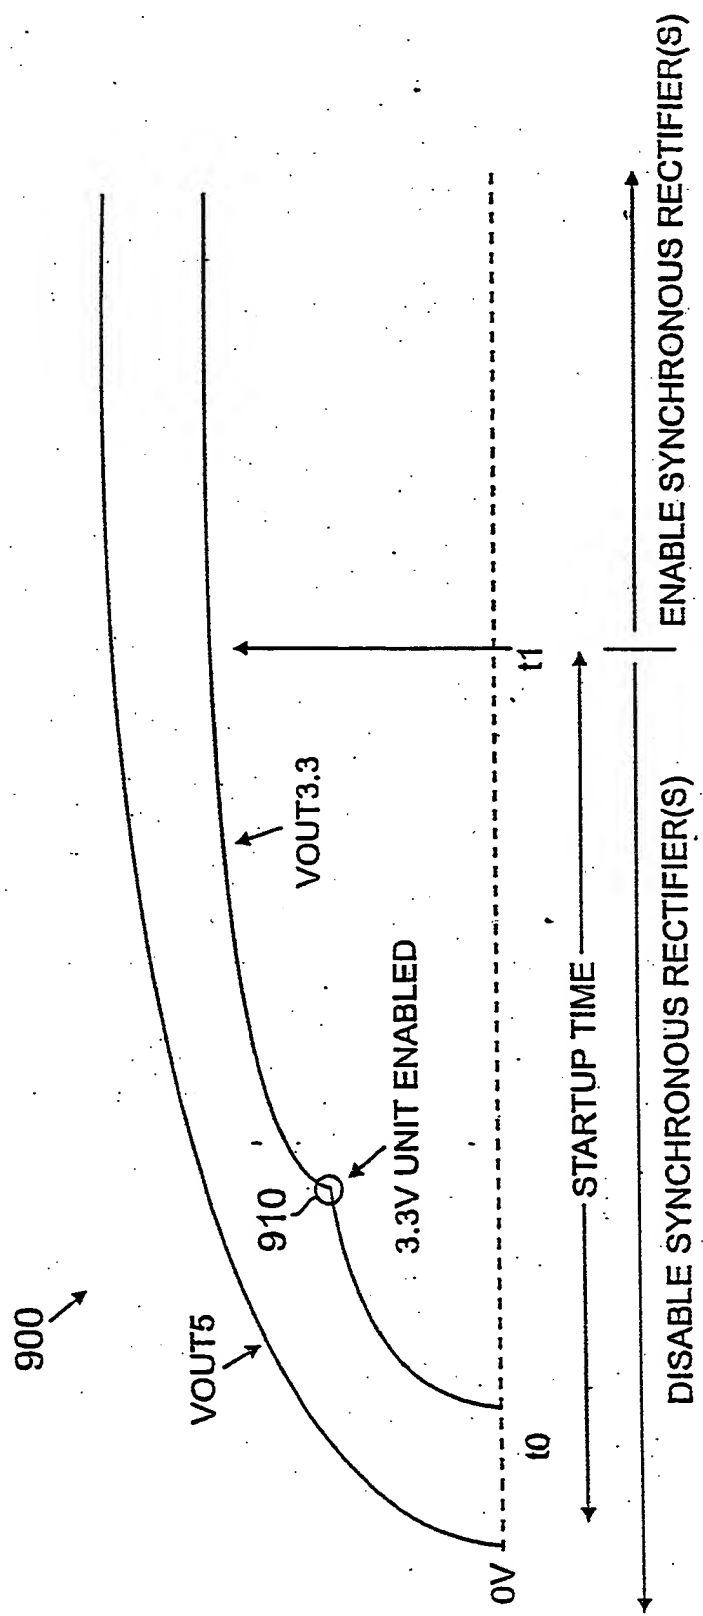


FIG. 9